

PSM 107110  
E: 507729.057  
N: 7035799.145  
RL: 6.584m

LOT 8  
SP341200

LOT 7  
SP341200

6  
1200

LOT 9  
SP341200

LOT 10  
SP341200

LOT 11  
SP341200












LOT 12  
SP341200

LOT 13  
SP341200

LOT 14  
SP341200

LOT 40  
SP341200

LOT  
SP341

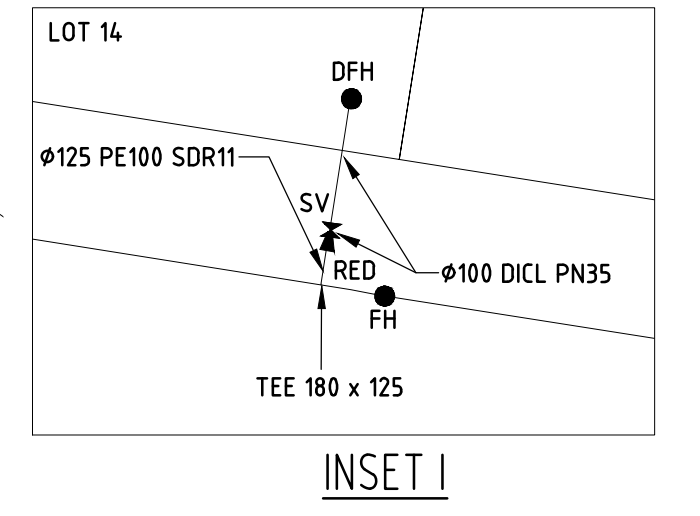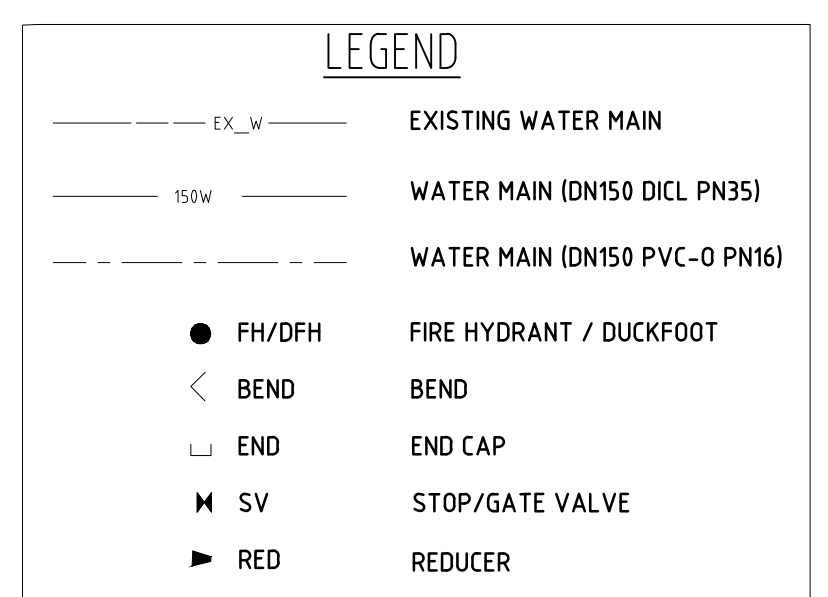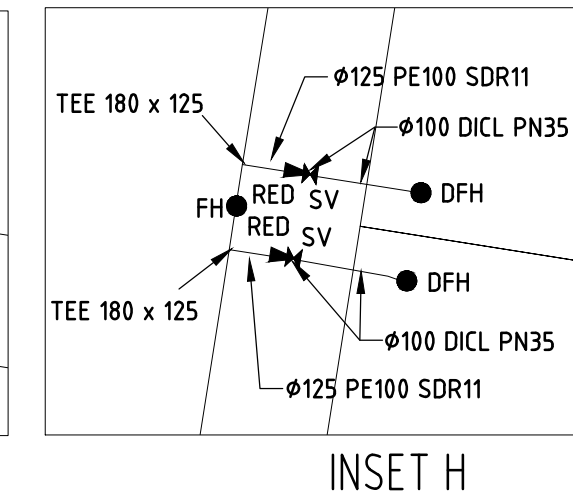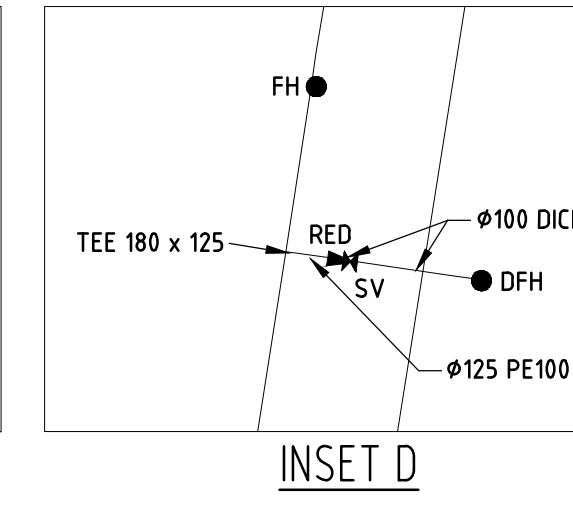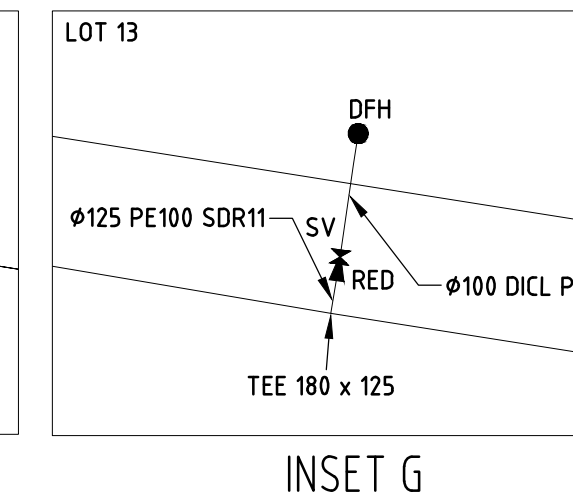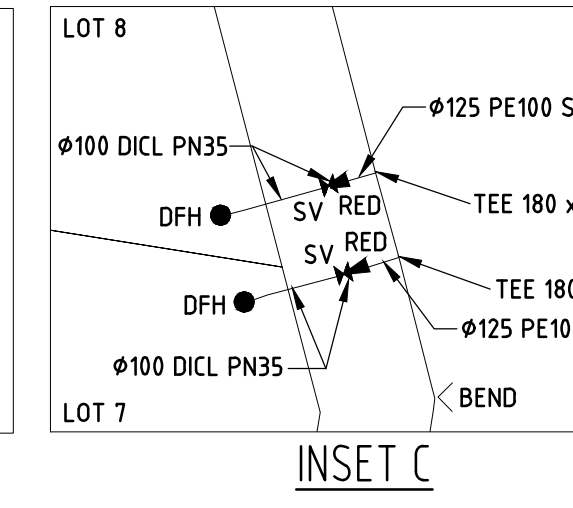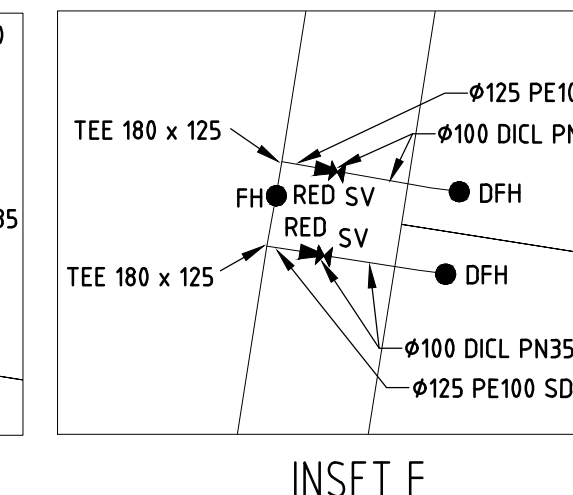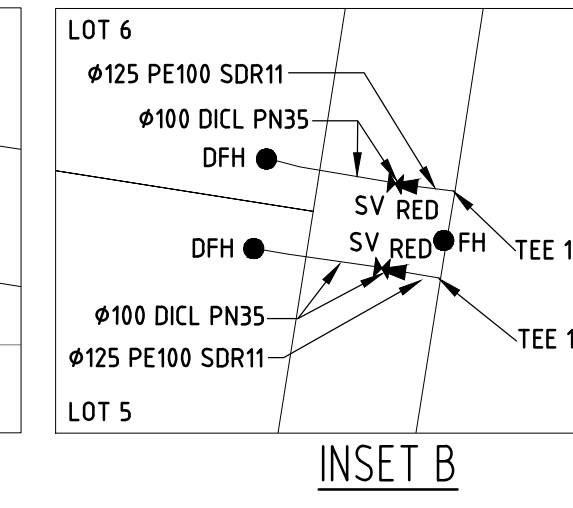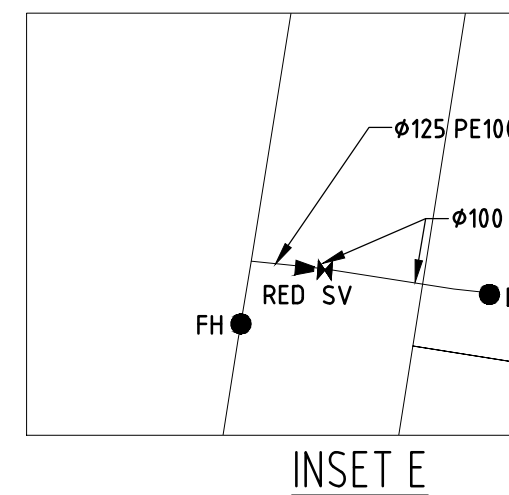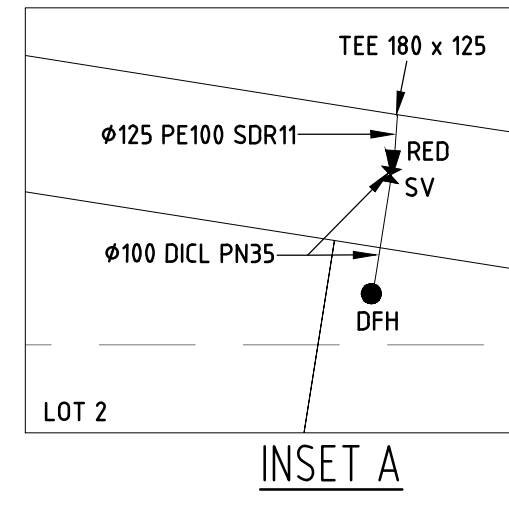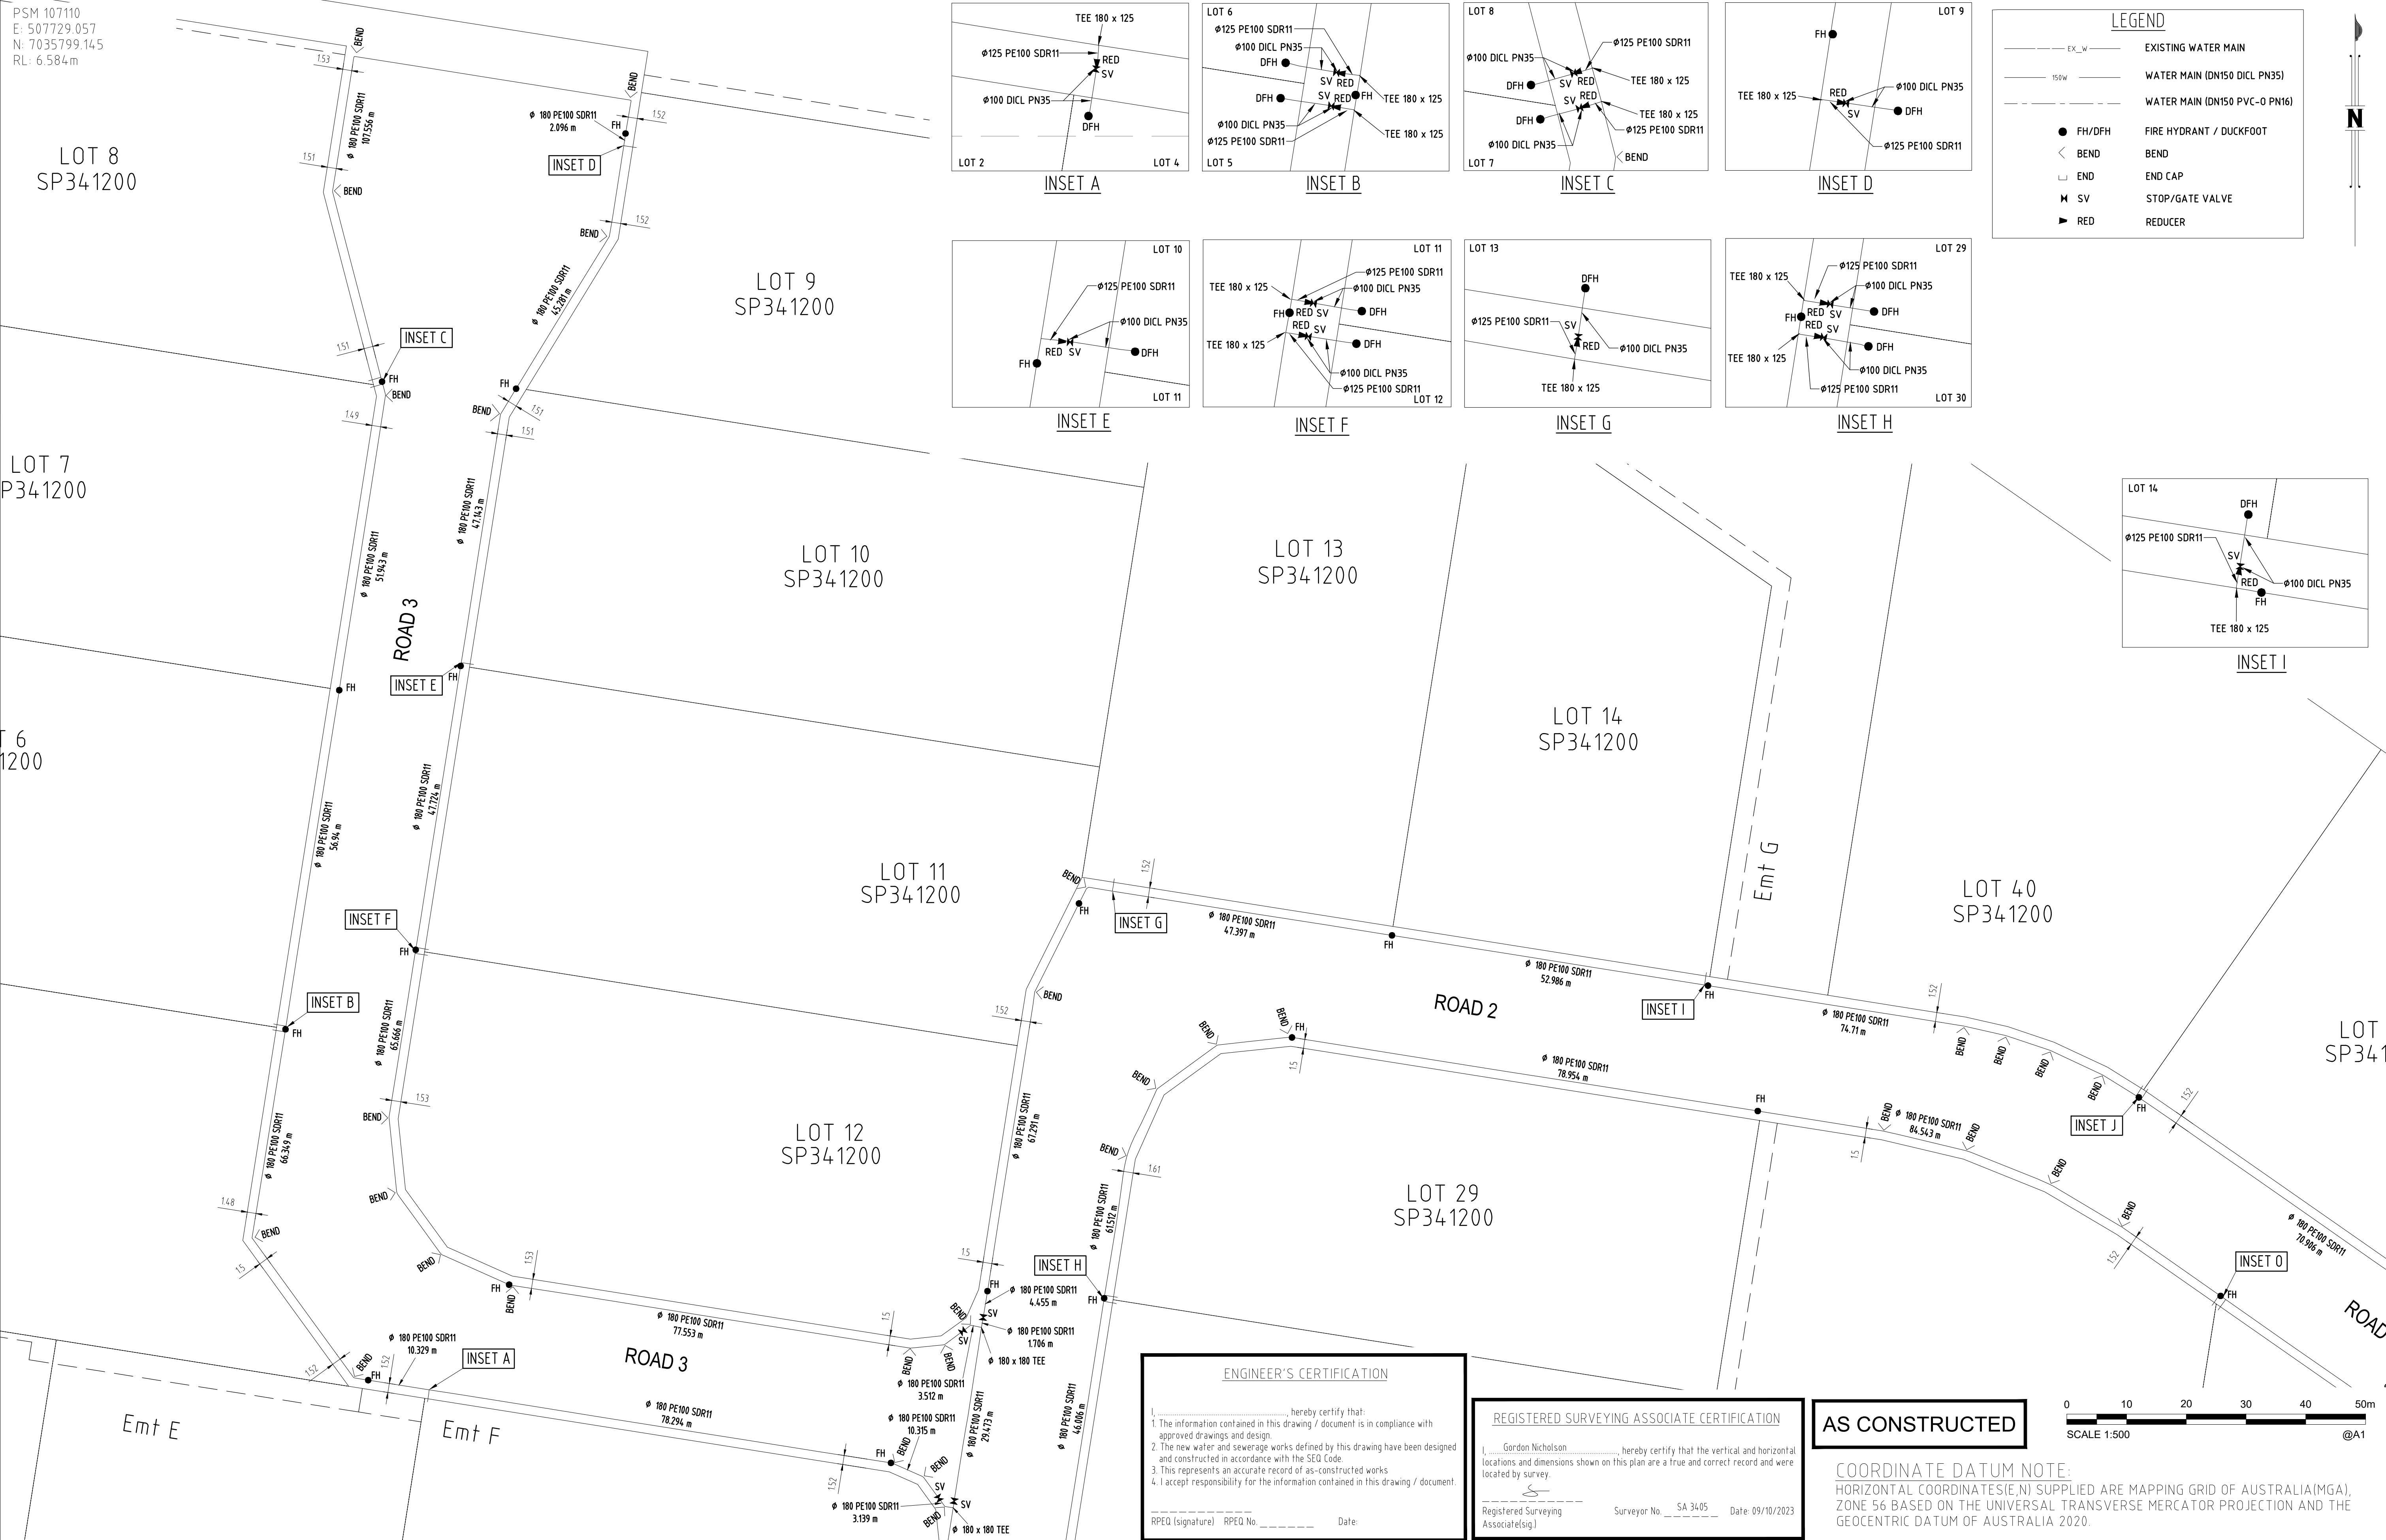

**ENGINEER'S CERTIFICATION**

I, \_\_\_\_\_ hereby certify that:  
 1. The information contained in this drawing / document is in compliance with approved drawings and design.  
 2. The new water and sewerage works defined by this drawing have been designed and constructed in accordance with the SEQ Code.  
 3. This represents an accurate record of as-constructed works.  
 4. I accept responsibility for the information contained in this drawing / document.


RPEQ (signature) RPEQ No. \_\_\_\_\_ Date: \_\_\_\_\_

**REGISTERED SURVEYING ASSOCIATE CERTIFICATION**

I, Gordon Nicholas, hereby certify that the vertical and horizontal locations and dimensions shown on this plan are a true and correct record and were located by survey.

Registered Surveying Associate (sig.) Surveyor No. SA 3405 Date: 09/10/2023

**AS CONSTRUCTED**

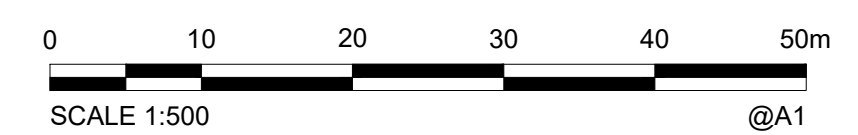

**COORDINATE DATUM NOTE:**  
 HORIZONTAL COORDINATES (E, N) SUPPLIED ARE MAPPING GRID OF AUSTRALIA (MGA), ZONE 56 BASED ON THE UNIVERSAL TRANSVERSE MERCATOR PROJECTION AND THE GEOCENTRIC DATUM OF AUSTRALIA 2020.

A1	A	09/10/2023	AS CONSTRUCTED	PMC	DAM	JF
	INDEX	DATE	REVISIONS	DRAWN	CHECKED	PASSED

DRAWN	PMC	09/10/2023
CHECKED	DAM	09/10/2023
PASSED	JF	-
INITIALS	DATE	

99 Sandalwood Lane, Forest Glen QLD 4556  
 P: 07 5438 3300 F: 07 5438 3388 E: admin@shadcivil.com.au

**Unitywater**

UNITYWATER APPROVAL No. 202001622650-AMD02  
 SUNSHINE COAST INDUSTRIAL PARK STAGE 2  
 AS CONSTRUCTED - WATERMAIN  
 SHEET 2 OF 5

SHEET 2 OF 5 SHEETS	SCALE 1:500
REVISION DATE 09/10/2023	REVISION A
DISCIPLINE CODE C	
DRAWING NO. U-2022-4384-WAT-02	